FilmL.A., Inc.
6255 W Sunset Blvd, 12th Floor
Hollywood, CA 90028
t: (213)977-8600 - f: (213)977-8601
www.filmla.com

Summary Information

Permit No: F00152611-B **Type of Permit:** FILMING **Release Date:** 06/11/2019

Production Company GRACE & FRANKIE PRODUCTIONS, LLC

Insured Company Name GRACE & FRANKIE PRODUCTIONS, LLC

Contact Phone No. 1 323-956-1800
Contact Phone No. 2
Fax 323-862-2270
Address 5555 MELROSE AVENUE, BOW BLDG, 2ND FLOOR
LOS ANGELES, California 90038

Production Title GRACE & FRANKIE #613

Type of Production TV Sitcom

Producer Joanne Toll

Director Marta Kauffman

1st AD Warren Grey

Production Manager Joan Van Horn

FilmL.A. Coordinator CJ Leavens

Location Manager Greg Lazzaro
Primary Phone Mobile - 310-850-2249
Secondary Phone

Location Assistant TBD TBD
Primary Phone Mobile - 555-555-5555
Secondary Phone

Fees

LA COUNTY BEACH USE FEE $400.00

Total Permit Fee $400.00

Number of Locations 1

NOT A PERMIT

FilmL.A., Inc.
6255 W Sunset Blvd, 12th Floor
Hollywood, CA 90028
t: (213)977-8600 - f: (213)977-8601
www.filmla.com

Summary Information

Location

Permit Number	F00152611-B	**Location Manager**	Greg Lazzaro
Production Company	GRACE & FRANKIE PRODUCTIONS, L...	Primary Phone	Mobile - 310-850-2249
Insured Company	GRACE & FRANKIE PRODUCTIONS, L...	Secondary Phone	
Production Title	GRACE & FRANKIE #613		

Location Address 7103 Westward Beach Rd, Unincorporated Los Angeles, CA 90265

Location Name POINT DUME / WESTWARD BEACH

Location Type Beach

Location Description POINT DUME / WESTWARD BEACH

Film Dates 6/12/2019 - 6/12/2019 07:00 - 17:00 1 day

Open or Closed to the Public Open

Generic Conditions *Certain service and personnel fees required by jurisdictional agencies are not collected by FilmL.A. Any such fees must be paid directly to the appropriate agency, and a separate invoice will be provided to the permittee.
All vehicles must be parked on private property
Must comply with attached Beaches and Harbors Conditions
Must Maintain 5' Clearance on Sidewalks/Walkways
Must maintain local/emergency access
No cast or crew parking on area streets
No interference with merchant activity.
No interference with vehicular or pedestrian traffic

Please see attached documents
Zuma Beach Lot 1.pdf
Zuma Beach Lots 2 3 4.pdf
Pt Dume Lot.pdf
ZUMA LOT 12 - FILM PARKING MAP 130 SPACES MAX.pdf
PointDume-WestwardBeach_SpecialFilmingConditions_2011-08.pdf
GenFilmPermitConditions_2012-03-01.pdf
ParkingGuidelines_2012-03-01.pdf

Equipment on Location

Type	Quantity
5 or 10 ton trucks	4
Cast/Crew vehicles	60
Catering Truck	1
Cranes	1
Cube Trucks	3
Generator	1
Motor Homes	2

Personnel on Location

Type	Quantity
Cast	5
Crew	80
LA County FSA assigned	1

NOT A PERMIT

FilmL.A., Inc.
6255 W Sunset Blvd, 12th Floor
Hollywood, CA 90028
t: (213)977-8600 - f: (213)977-8601
www.filmla.com

Summary Information — Location

Permit Number	F00152611-B	**Location Manager**	Greg Lazzaro
Production Company	GRACE & FRANKIE PRODUCTIONS, L...	Primary Phone	Mobile - 310-850-2249
Insured Company	GRACE & FRANKIE PRODUCTIONS, L...	Secondary Phone	
Production Title	GRACE & FRANKIE #613		

Portable restrooms	1
Trailers	3
Vans	3

Filming Activities Equipment on sand; Exterior Dialogue; Walk & talk on sand; No water activity; 5 Gators; Self-driving Titan crane on sand; PD/WB: 6/12, TOWER 1;

Jurisdiction **Political:** Los Angeles County - Supervisor District 3 **Police:** Los Angeles County Sheriff **Fire:** Los Angeles County Fire Department

Thomas Guide **Page:** 667 **Grid:** E5

Location Notes A City of Malibu permit is required in addition to the FilmL.A. still/photo film permit.
The City of Malibu does not require students to get film permits.
Must comply with attached Beaches and Harbors conditions

Beaches & Harbors and Parking Management are not responsible for coning off parking spaces in approved parking lots.

Lifeguard fees are not collected by FilmL.A. These fees are charged directly by DBH for services rendered. Companies must provide a valid billing address for this purpose.

NO FILMING ALLOWED ON SUNDAYS.
FILMING MUST BE WITHIN HOURS OF 0700HRS-2200HRS ONLY PER CITY OF MALIBU FILMING ORDINANCE
FSA MAY BE REQUIRED IF CAST/CREW OVER 35 PEOPLE.

A minimum of 8 feet of vertical clearance must be maintained if flying cables over the bike path, to be approved by LA County Roads.

Approvals	LOS ANGELES COUNTY DEPARTMENT OF BEACHES & HARBORS	Marisol Camey
	LOS ANGELES COUNTY PUBLIC WORKS - FINAL APPROVERS	Lorenzo Villa - Final Approver

Coordinator Note LA County Fire Permit #19-1482-71/110 FSA required

Coordinator Note Not permitted to use, store equipment on or film on lifeguard towers in area. No driving on beach to capture scenes. Maximum of 1 gator on beach at any time to

NOT A PERMIT

FilmL.A., Inc.
6255 W Sunset Blvd, 12th Floor
Hollywood, CA 90028
t: (213)977-8600 - f: (213)977-8601
www.filmla.com

Summary Information — Location

Permit Number	F00152611-B	**Location Manager**	Greg Lazzaro
Production Company	GRACE & FRANKIE PRODUCTIONS, L...	Primary Phone	Mobile - 310-850-2249
Insured Company	GRACE & FRANKIE PRODUCTIONS, L...	Secondary Phone	
Production Title	GRACE & FRANKIE #613		

upload and unload equipment only. Must not block emergency access route to cliff. Must not impede public use of bluff trail entrance at end of parking lot. Must not impede public use of parking lot. Not permitted to use natural trails leading to private homes. Must park within marked parking stalls and display all parking receipts to avoid citations. Must not block ingress and egress of parking lot entrance, exits or traffic ways.

Coordinator Note No Charge Rider B created to release remaining locations.

Parking

Base Camp
Location Type : Other Location
Zuma Beach, Malibu, CA, 90265

Crew Parking
Location Type : Other Location
Zuma Beach, Malibu, CA, 90265

Parking Notes

Requesting 100 spaces in lot at location
Zuma Beach - Requesting 130 spaces in lot 12, 36 spaces in lot 11 & 24 spaces in lot 10
Moving into lot 12 (only) 6/11, 1800-2359 (Trucks/equipment overnight)

ZUMA: 6/12, LOTS 10, 11 & 12 (All lots for film date)
Zuma Beach:
130 spaces in lot 12 (Please have the chain dropped in this lot) (Moving into lot 12 only 6/11, 1800-2359 -Trucks overnight)
36 spaces in lot 11
24 spaces in lot 10
All three lots: 6/12, 0500-2359
Chain dropped in lot 12 -- 6/11, 1800-2359 & 6/12, 0700-2100

NOT A PERMIT

ZUMA COUNTY BEACH
PARKING LOT #1

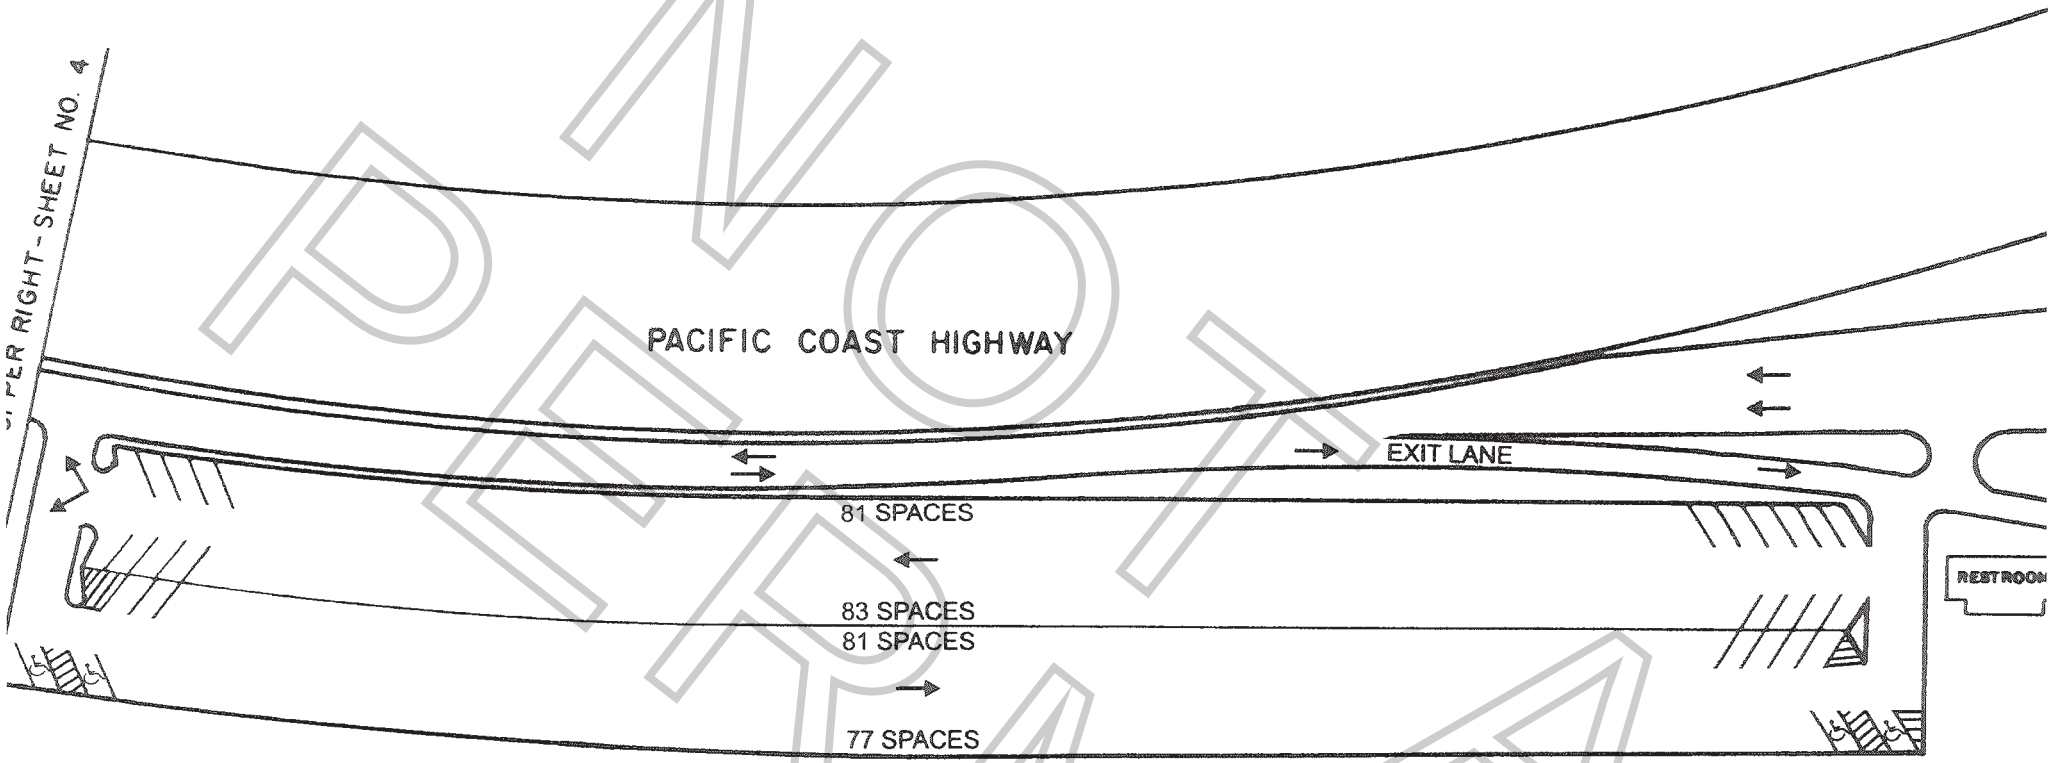

Map not to scale.

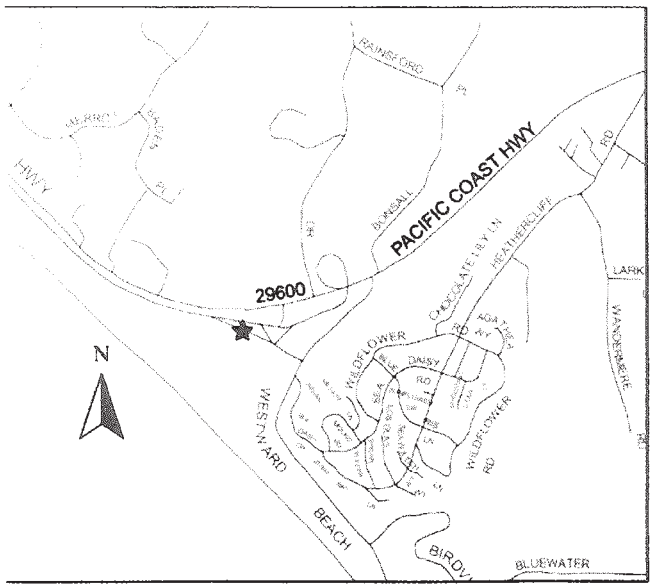

Lot 1 okay for crew/personal vehicles only;
No large trucks or basecamp.

SHEET 3 of 8

REGULAR SPACES	322
DISABLED	4
TOTAL	326

This map was produced in whole or in part from THOMAS BROS MAPS(r) digital database fi
and reproduced with permission granted by THOMAS BROS MAPS(r). All rights reserved

L.A. COUNTY DEPARTMENT OF BEACHES AND HARBORS Revised 5 / 2012 by C

Permit #F0015261

NOT A PERMIT

ZUMA COUNTY BEACH
PARKING LOTS #2, 3, 4

NOT A PERMIT

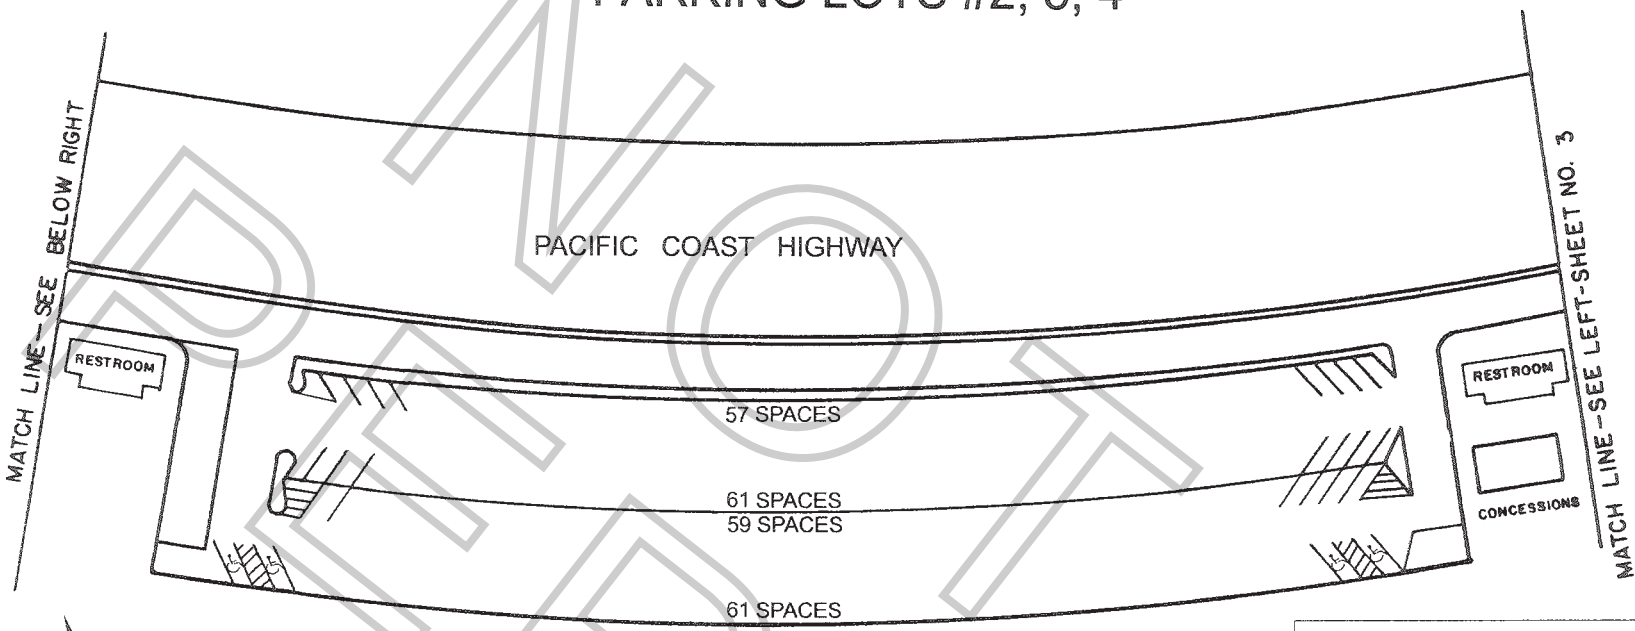

Map not to scale.

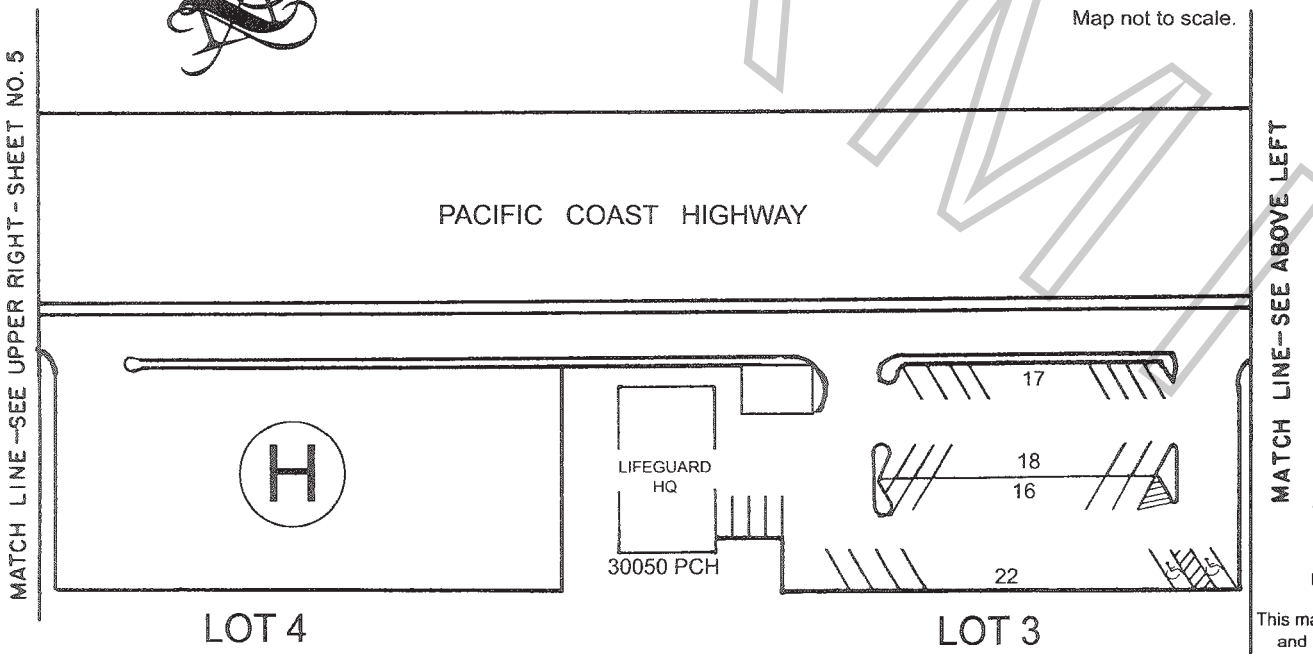

Map not to scale.

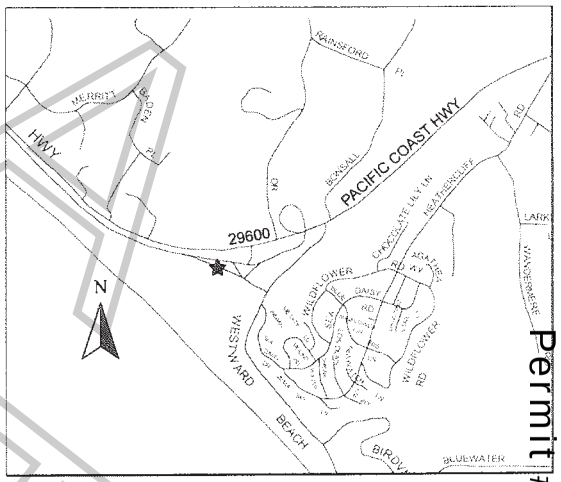

SHEET 4 of 8

REGULAR SPACES	317
DISABLED	6
TOTAL	323

L.A. COUNTY DEPARTMENT OF BEACHES AND HARBORS Revised 5 / 2012 by CLS

This map was produced in whole or in part from THOMAS BROS MAPS(r) digital database files and reproduced with permission granted by THOMAS BROS MAPS(r). All rights reserved.

Permit #F0015261-D

POINT DUME COUNTY BEACH

PERMIT NOT

BASE OF CLIFF

SPACES TO END OF LOT →

ESTWARD
ACH ROAD

69 SPACES

#2 RESTROOM & LIFEGUARD STATION

(~6900 Westward Bch Rd)

No parking or staging in cul-de-sac/turnabout area.

MATCH LINE– SEE ABOVE

BASE OF CLIFF

SPACES BETWEEN BUILDINGS

#3 RESTROOM

(~7130 Westward Bch Rd)

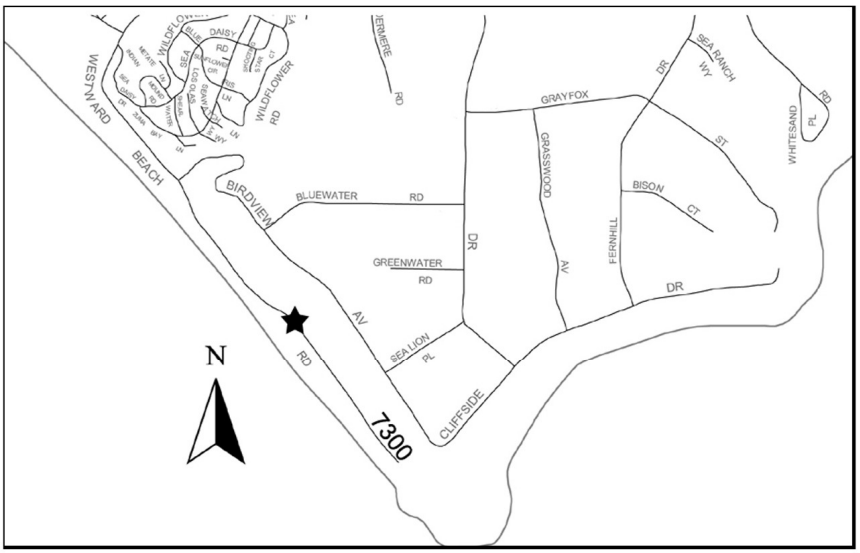

Map not to scale.

Pay and Display Machine

REGULAR SPACES	375	3
DISABLED	7	
TOTAL	382	3

This map was produced in whole or in part from THOMAS BROS MAPS(r) digital database and reproduced with permission granted by THOMAS BROS MAPS(r). All rights reserve

L.A. COUNTY DEPARTMENT OF BEACHES AND HARBORS

Revised 11 / 2011 by
(source: F&PM staff)

Permit #F0015261

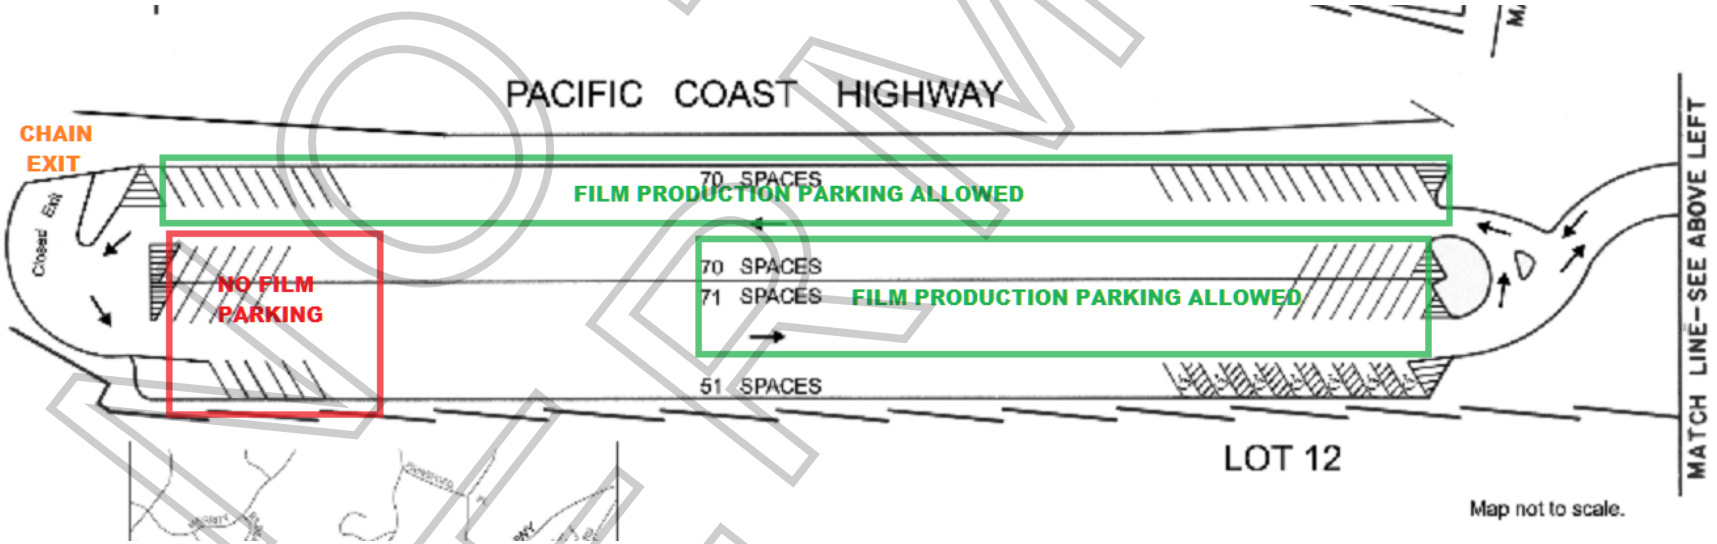
PACIFIC COAST HIGHWAY
CHAIN EXIT
Closed Exit
70 SPACES
FILM PRODUCTION PARKING ALLOWED
NO FILM PARKING
70 SPACES
71 SPACES
FILM PRODUCTION PARKING ALLOWED
51 SPACES
LOT 12
MATCH LINE–SEE ABOVE LEFT
Map not to scale.

NOT A PERMIT

Special Filming Conditions for Los Angeles County Beaches

POINT DUME BEACH

The Special Filming Conditions described below will be included in the terms and conditions of permits issued for filming in this area and are in addition to the standard terms and conditions applicable to filming permits generally. While these Special Filming Conditions will be included as terms if a permit for filming in this area is issued, they are not intended to, and do not, establish the criteria or standards for determining whether or not a particular permit (or permits) will be issued for this area. The decision whether or not a particular permit (or permits) will be issued is vested in the discretion of the appropriate City or County department or their designees (including FilmL.A., Inc.), to be exercised consistent with public health, safety and general welfare, and applicable land-use ordinances.

These conditions have been drafted by the Los County Department of Beaches & Harbors to help facilitate filming on Los Angeles County Beaches.

- No trucks larger than 40 feet will be allowed in parking lot.
- No filming, parking or staging in red cul-de-sac area.
- No admittance to parking lots prior to 7:00 a.m.
- Parking lot closes at dusk. Parking attendant required after hours.
- A City of Malibu permit is required in addition to the FilmL.A. still photo film permit.

NOT A PERMIT

General Film Permit Conditions

1. Production company must have a finalized copy of the film permit, including General Film Permit Conditions and Parking Lot Guidelines on set at all times.

2. If use of Maintenance or Lifeguard personnel is required, it must be reflected on the permit and call times indicated. Lifeguards require 24-hour notice to be hired with a 4-hour minimum requirement. Maintenance also requires 24-hour notice to be hired. A County Lifeguard is required for any filming that occurs on a beach or parking lot after hours (2200-0600 hrs). There is an 8-hour minimum for all after hours filming.

3. Filming requests will be approved on a case-by-case basis.

4. Companies must cover and/or fly cables over pedestrian walkways and turf areas.

5. Filming must not interfere with Lifeguard or Maintenance activities at any time and must not interfere with scheduled beach or park activities or special events.

6. May not block public or emergency access at any time.

7. No catering or craft services allowed on pedestrian walkways or bike path.

8. No animals allowed unless prior approval from DBH, FilmL.A., and local municipal Animal Control office and is indicated on permit. All dogs must remain on leashes and off sand when not filming.

9. No driving scenes allowed on sand or turf areas.[1]

10. Tent use must be indicated on permit. No staking into parking lot. Sandbags or closed water containers must be used for anchoring items on the sand.

11. Emergency access area (marked in red) cannot be used at any time. Exceptions subject to review and approval by DBH Parking and the Fire Department/Lifeguards.

12. All water activities require a Lifeguard to be hired with a minimum of 4 hours of service.

13. Production company may be required to hire a FilmL.A. Monitor if the production or filming negatively impacts public safety or beach operations.

14. Production personnel must be assigned to power cables and/or coned off areas when posing a safety concern.

15. A safety officer must be assigned to motorized equipment when on the sand.

16. Filming and clean-up must be complete by 10:00 p.m. unless otherwise authorized by DBH.

[1] Excludes Dockweiler State Beach

NO PERMIT

17. No chemicals on the beach or in the water unless approved by the Director and Fire Chief.

18. Production companies must remove all trash and debris resulting from activity.

19. Playback and amplified sound must be kept to moderate levels after 10:00 p.m. so long as not to disturb nearby residents. Prior approval required from DBH and FilmL.A.[2]

20. Lifeguard towers must be indicated on permit.

21. Digging holes in the sand less than 4 feet deep must be approved by the Director and indicated on permit. Production companies must secure holes in the sand by providing trench shoring, an exclusionary zone with caution tape, staging safety personnel outside the exclusionary zone for rapid rescue, a harness and safety rigging for any person in the trench.

22. All personal motorized watercrafts and vessels must remain 300 yards from the shoreline.

23. No launching or landing of personal motorized watercrafts or vessels from beach.[3]

24. For safety purposes, flagmen are required for all heavy equipment, machinery, and vehicles that are operated on the beach, including during the loading and unloading of filming equipment on the beach.

25. Proof of insurance meeting each jurisdiction involved is required.

26. Community Surveys must be obtained from residences before filming is permitted to take place between the hours of 10 p.m. to 7:00 a.m. Survey radius will be determined by FilmL.A. based on production activity and parking.

27. Use of 4-wheel drive vehicles on the beach are approved for equipment transporting only. No joy riding in vehicles on the beach at any time. Vehicle speed is limited to 5 m.p.h. at all times.

28. In the event of flowing storm drains, film shoots with water activity may be suspended for a period up to 72 hours due to high bacteria levels in ocean waters. Production companies may also be denied access to certain areas on the beach where there is sewage or required storm drain cleanup by DBH Maintenance staff. These decisions will be made by DBH in consultation with L.A. County Lifeguards and FilmL.A.

29. If a situation arises in which the Lifeguard Captain deems unsafe, a consultation with the on-scene production manager will be conducted to determine safer alternatives. Filming will be suspended until safety measures are adopted.

NOT A PERMIT

[2] Playback and amplified sound is not allowed at Burton Chace Park
[3] Exclusions for personal motorized watercrafts at Venice Beach

PARKING GUIDELINES
FOR THE USE OF COUNTY PARKING LOTS
OPERATED BY PARKING MANAGEMENT COMPANY

1. Companies must make parking arrangements for parking in L.A. County parking lots with DBH's parking contractor prior to first film date.

2. All production companies must have prior authorization for in/out parking privileges in any L.A. County parking lot. Arrangements must be made in advance with DBH's parking contractor. Film companies paying upon entry, without prior arrangements, will not be allowed in and out privileges.

3. All production vehicles must display a parking receipt on dashboard of vehicles and must only enter lots during approved/authorized dates and times. Failure to display parking receipts on dashboard of vehicle or unauthorized entry will result in a parking citation.

4. The production company may not block public or emergency access or park vehicles in any front row adjacent to local businesses at Venice Beach at any time (see parking lot maps).

5. The production company is prohibited from parking in disabled parking spaces, short-term metered parking and from blocking any pay stations at any time (no exceptions).

6. A walkthrough is to be conducted after the production company has parked all of its vehicles. This walkthrough is to be done by the location manager (or designated representative) and a parking contractor supervisor to determine the exact number of spaces being utilized and that number is called into the parking contractor's office. The location manager must make arrangements to meet again with the parking contractor supervisor at a designated time to confirm spaces prior to vacating the parking lot and again that number is called into the parking contractor's office.

7. The production company will be invoiced for any additional spaces occupied by cast/crew members' cars, equipment vehicles and cone-off spaces.

8. Production companies wanting to use parking spaces at one of the parking contractor operated parking lots on the beach or in the Marina del Rey area must contract the parking contractor directly (310.821.1081) and speak with office management. Normal business hours are Monday through Friday, 8:00 a.m. to 5:00 p.m.

9. Parking fees are not included on film permits. A film permit number must be provided to the parking contractor and the contractor will provide the production company estimated charges for the use of the parking lot(s). Payment arrangements must be made with the parking contractor directly at least one business day prior (and before 4:00 p.m.) for the use of the parking lot(s).

10. Cancellation of a parking contract must be done at least one day prior. Refunds will be given within ten to twelve weeks.

11. A parking contract does not constitute a film permit.

12. Sign removal in L.A. County parking lots is prohibited.

NOT A PERMIT